

**REMARKS**

No new matter has been added. The amendments to the claims address typographical and spelling errors, and improve antecedent basis. The amendments do not affect, or surrender, any scope of any claim as originally filed.


FIGS. 2, 3, 4, 6, and 7 have been amended herein. Specifically, FIG. 2 has been revised to add the reference numeral --38-- with two (2) appropriate lead lines and change the reference numeral "64" to --60--; FIG. 3 has been revised to add the reference numeral --38-- with two (2) appropriate lead lines and to add the lower case letter "l" to the corner above the reference numeral --48--; FIG. 4 has been revised to shift the broken grid lines of reference numeral --22-- to the left to line up with the broken grid lines of reference numerals --22-- and --21--; FIG. 6 has been revised to change the reference numeral "20" to --20'--, change the reference numeral "22" to --22'--, change the reference numeral "52" to --52'--, change the reference numeral "54" to --54'--, change the reference numeral "60" to --60'--, change the reference numeral "62" to --62'--; and FIG. 7 has been revised to change the reference numeral "46" to --46'--. No new matter has been added.

Transmittal of Formal Drawings (revised) is also enclosed herein.

The Applicants again request entry of the amendments as set forth herein prior to examination of the application on the merits.

Serial No. 10/731,878

Respectfully submitted,

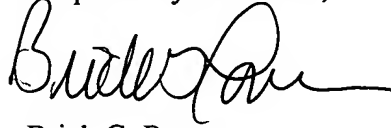A handwritten signature in black ink, appearing to read 'Brick G. Power', written over a horizontal line.

Brick G. Power

Registration No. 38,581

Attorney for Applicant(s)

TRASKBRITT

P.O. Box 2550

Salt Lake City, Utah 84110-2550

Telephone: 801-532-1922

Date: May 18, 2004

BGP/tlb:rmh

Enclosures: Annotated Sheets Showing Changes

\\Traskbritt1\Shared\DOCS\3051-6244US\68279.doc

# **APPENDIX**

**(ANNOTATED SHEETS SHOWING CHANGES OF FIGS. 2, 3, 4, 6, AND 7)**

**(Serial No. 10/731,878)**



1/5

10 →

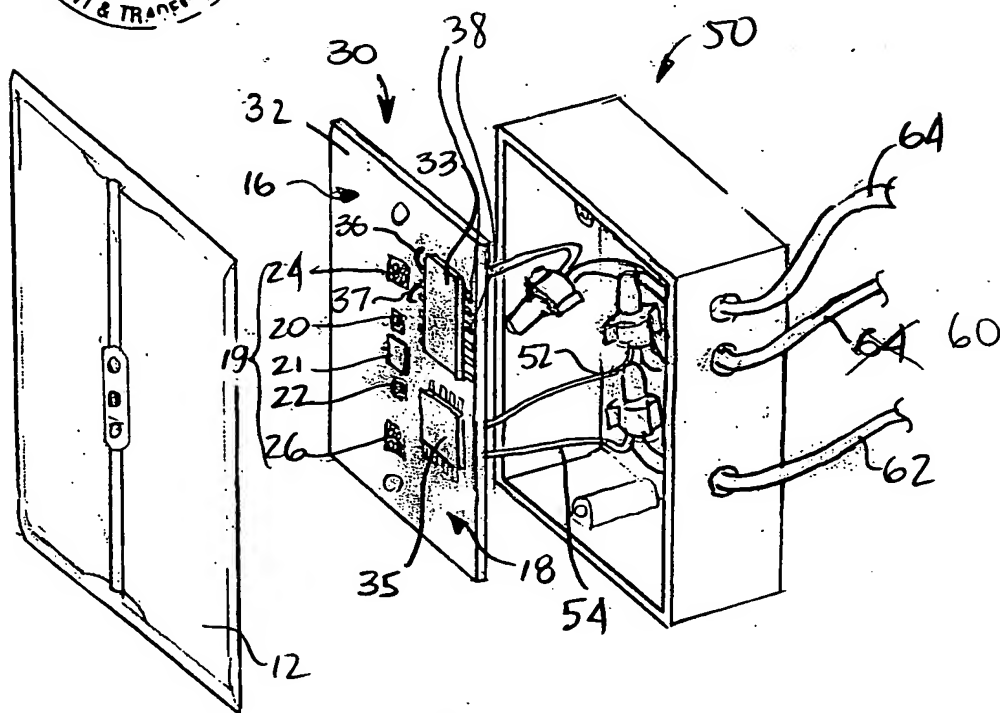


FIG. 2

10 →


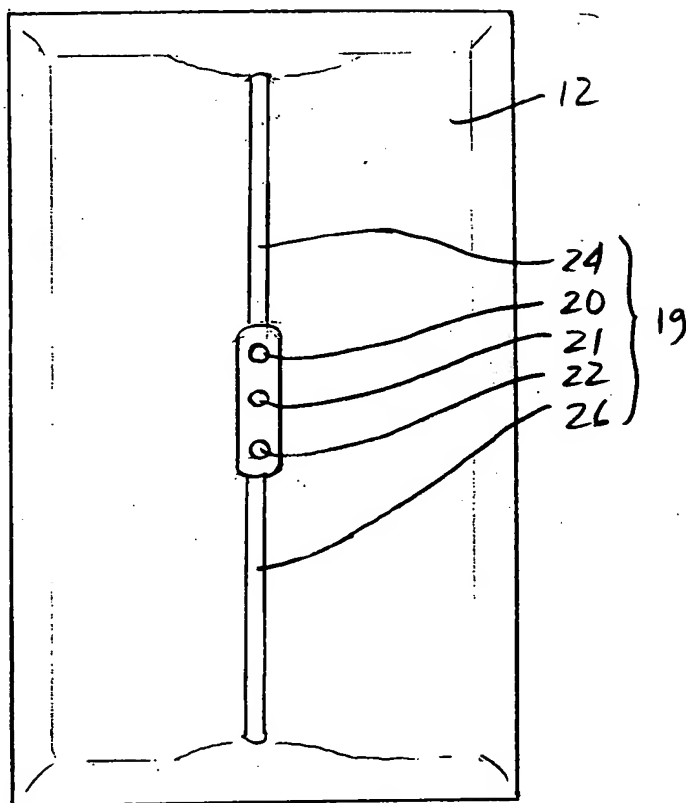


FIG. 1

Serial No. 10/731,878; Filing Date 12/8/2003  
Preliminary Amendment  
ANNOTATED SHEET SHOWING CHANGES


REV.	DESCRIPTION	DATE	APPROVED
P1	CHANGES MADE PER MARKUP 03NOV03.	K.W.M.	
P2	CHANGES MADE DURING LAYOUT 07NOV03.	K.W.M.	
P3	ADDED R20. CHGD A1, CR1, AND 10 RESISTORS.	17NOV03	K.W.M.

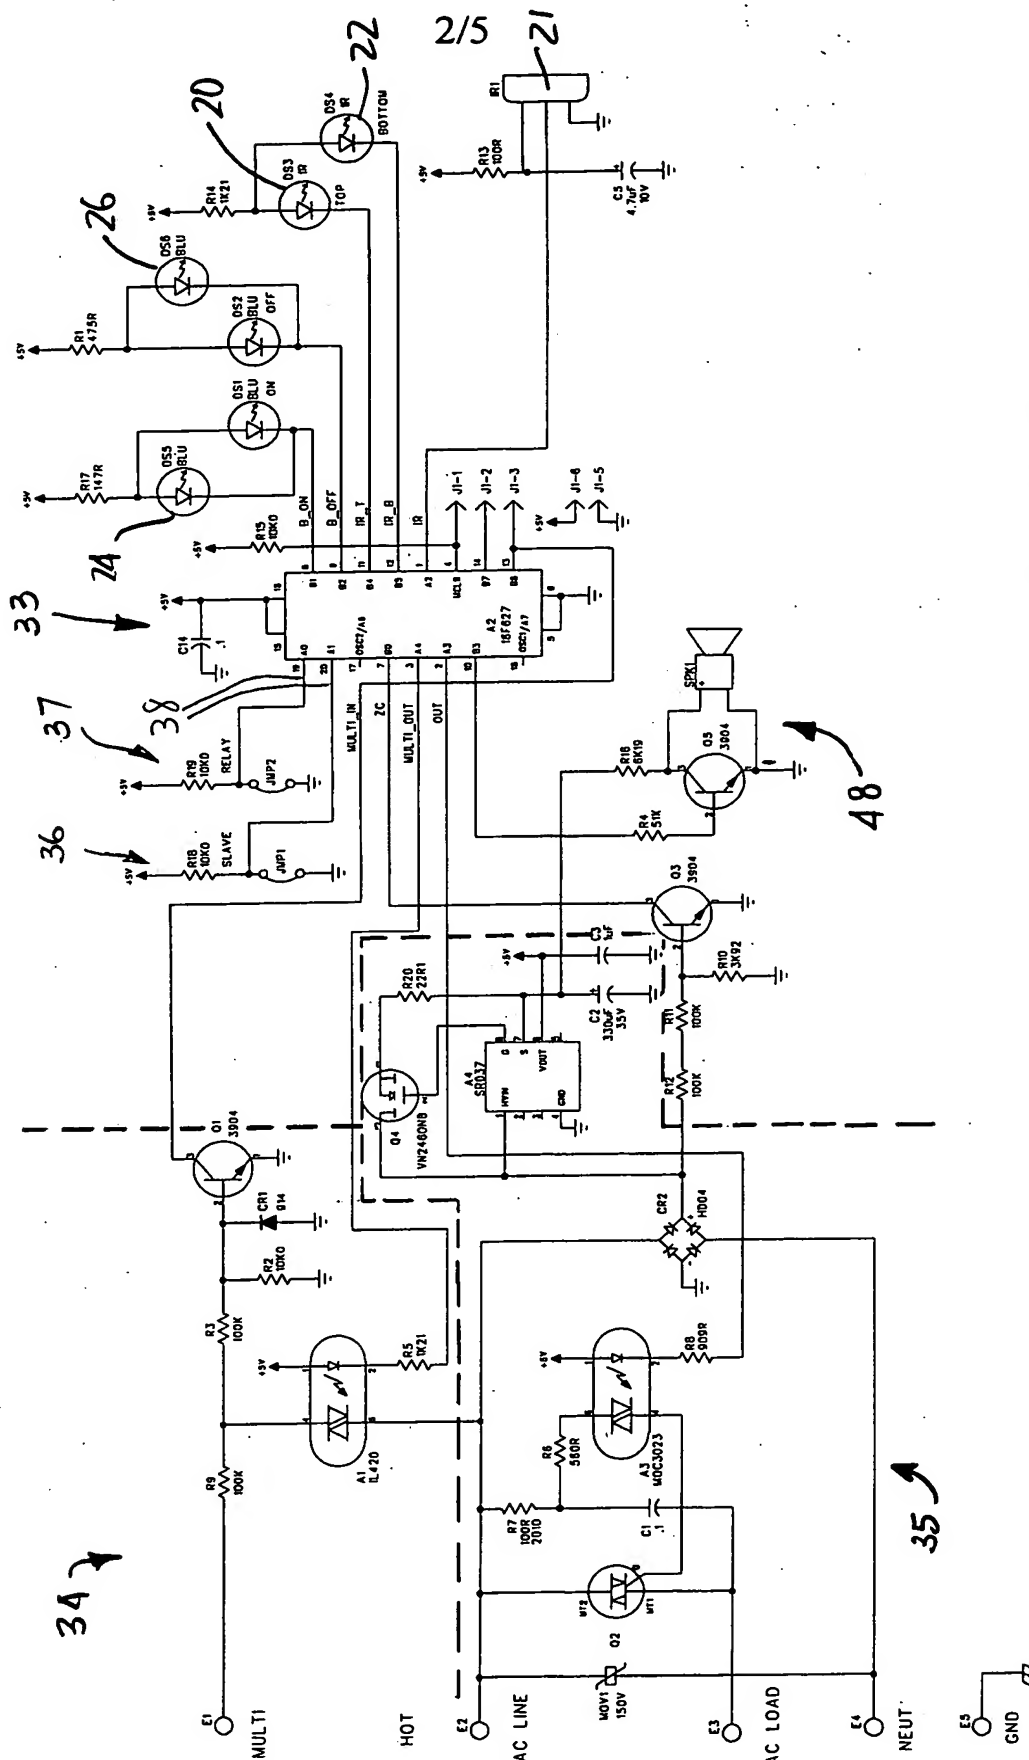

DESIGNED BY	D.E.M. 03NOV03	DATE	
APPROVED		DATE	
PROD. ENG.			
CAPACITOR VALUES ARE IN MICROFARADS (uF) UNLESS OTHERWISE SPECIFIED.			
RESISTOR VALUES ARE IN OHMS UNLESS OTHERWISE SPECIFIED.			
RESISTOR TOLERANCES WILL BE SHOWN AS FOLLOWS: UNLESS OTHERWISE SPECIFIED.			
100K = 100 OHMS 1%			
10K = 10K OHMS 1%			
100 = 100 OHMS 1%			
10K = 10K OHMS 1%			
FOR ADDITIONAL INFORMATION SEE BILL OF MATERIAL.			
FRESH ELECTRONIC FED DESIGNS		SCHEMATIC PHANTOM SWITCH DESIGN ENGINE	
SHEET	C	FED DWG NO.	104-00
REV	P3	SCALE	NONE
PHANTOMSW		SHEET 1 OF 1	

FIG. 3

3/5

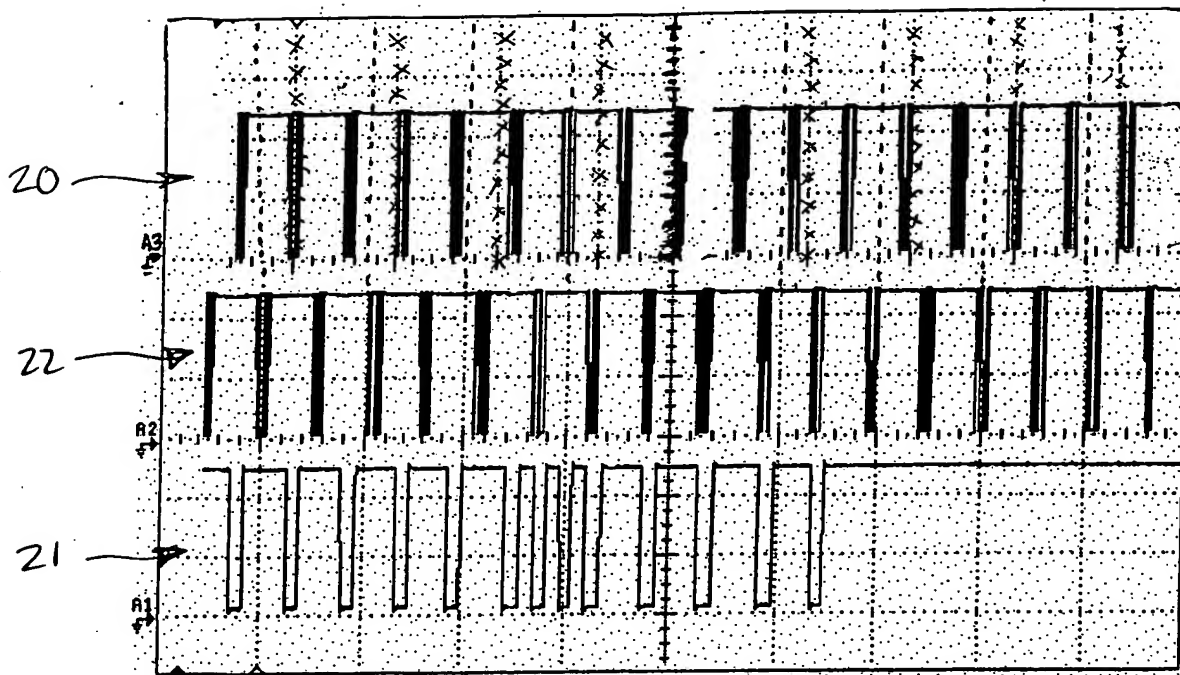

4/5

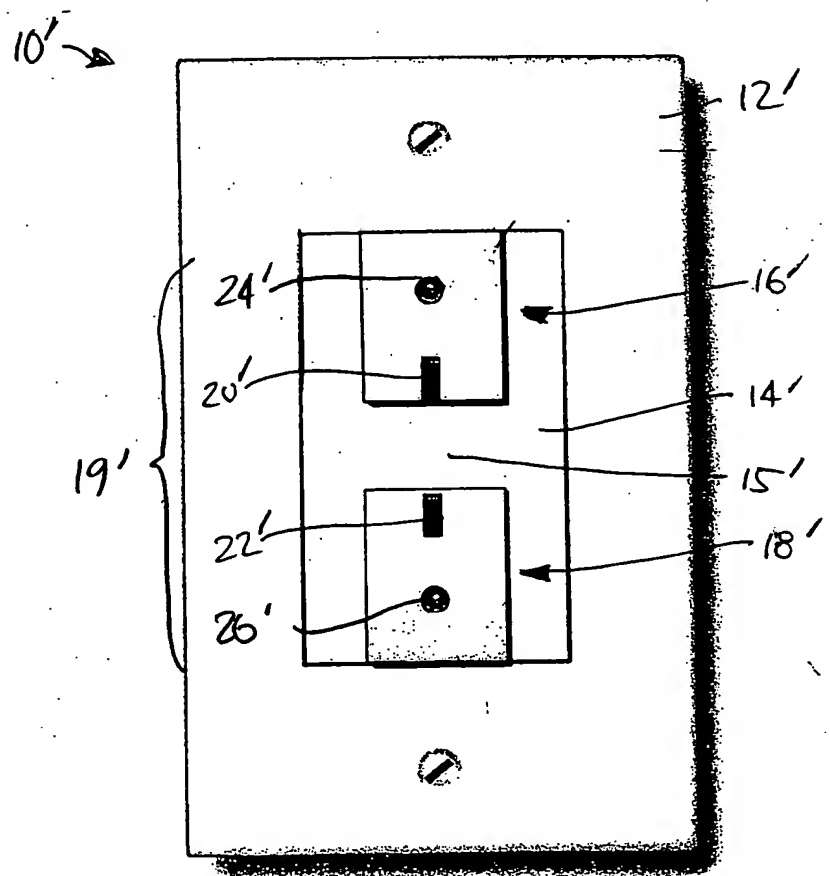
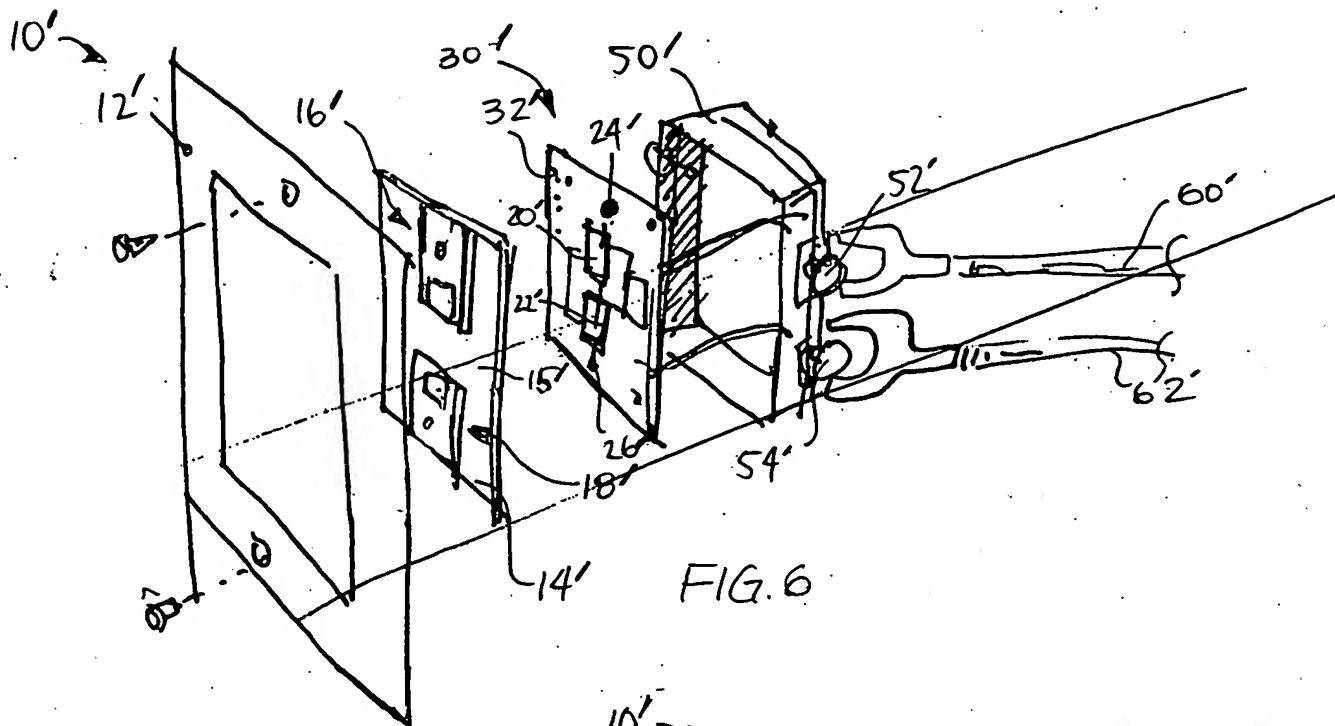


FIG. 5

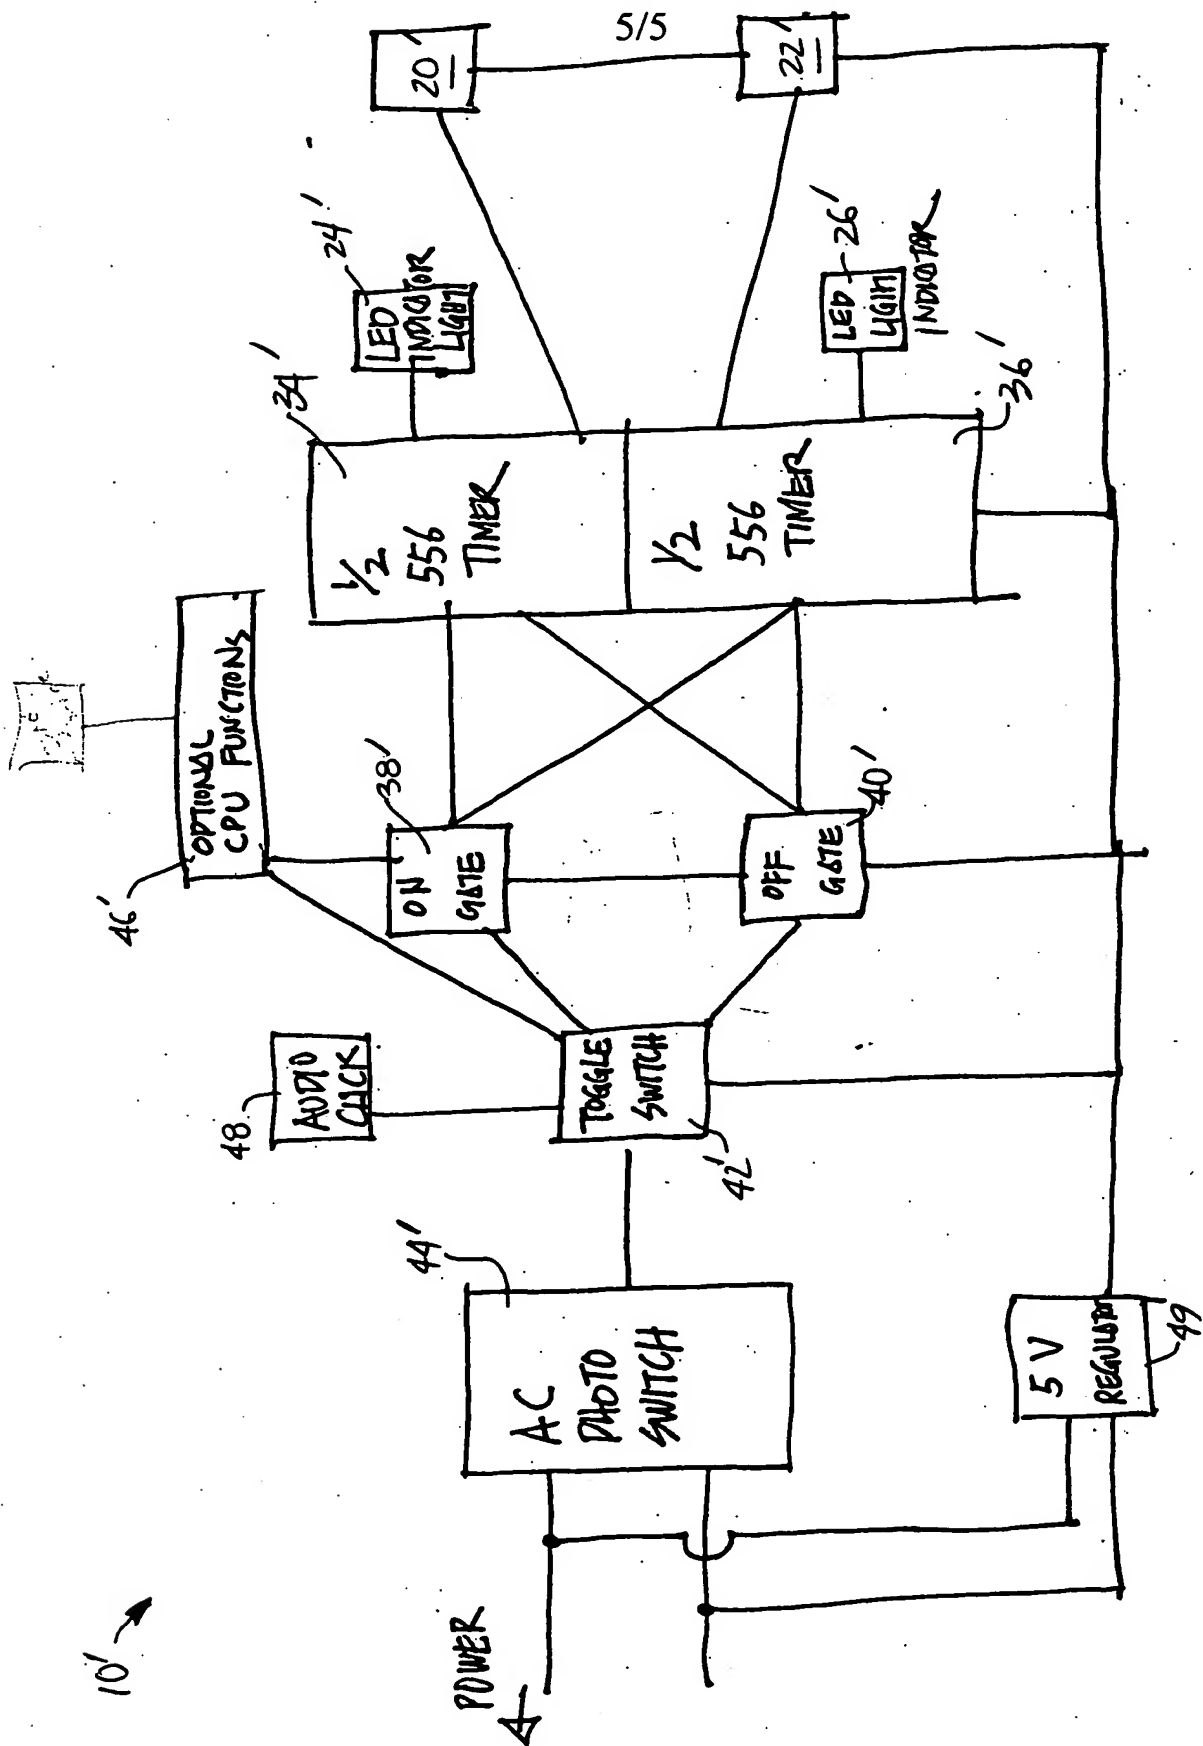


FIG. 7